
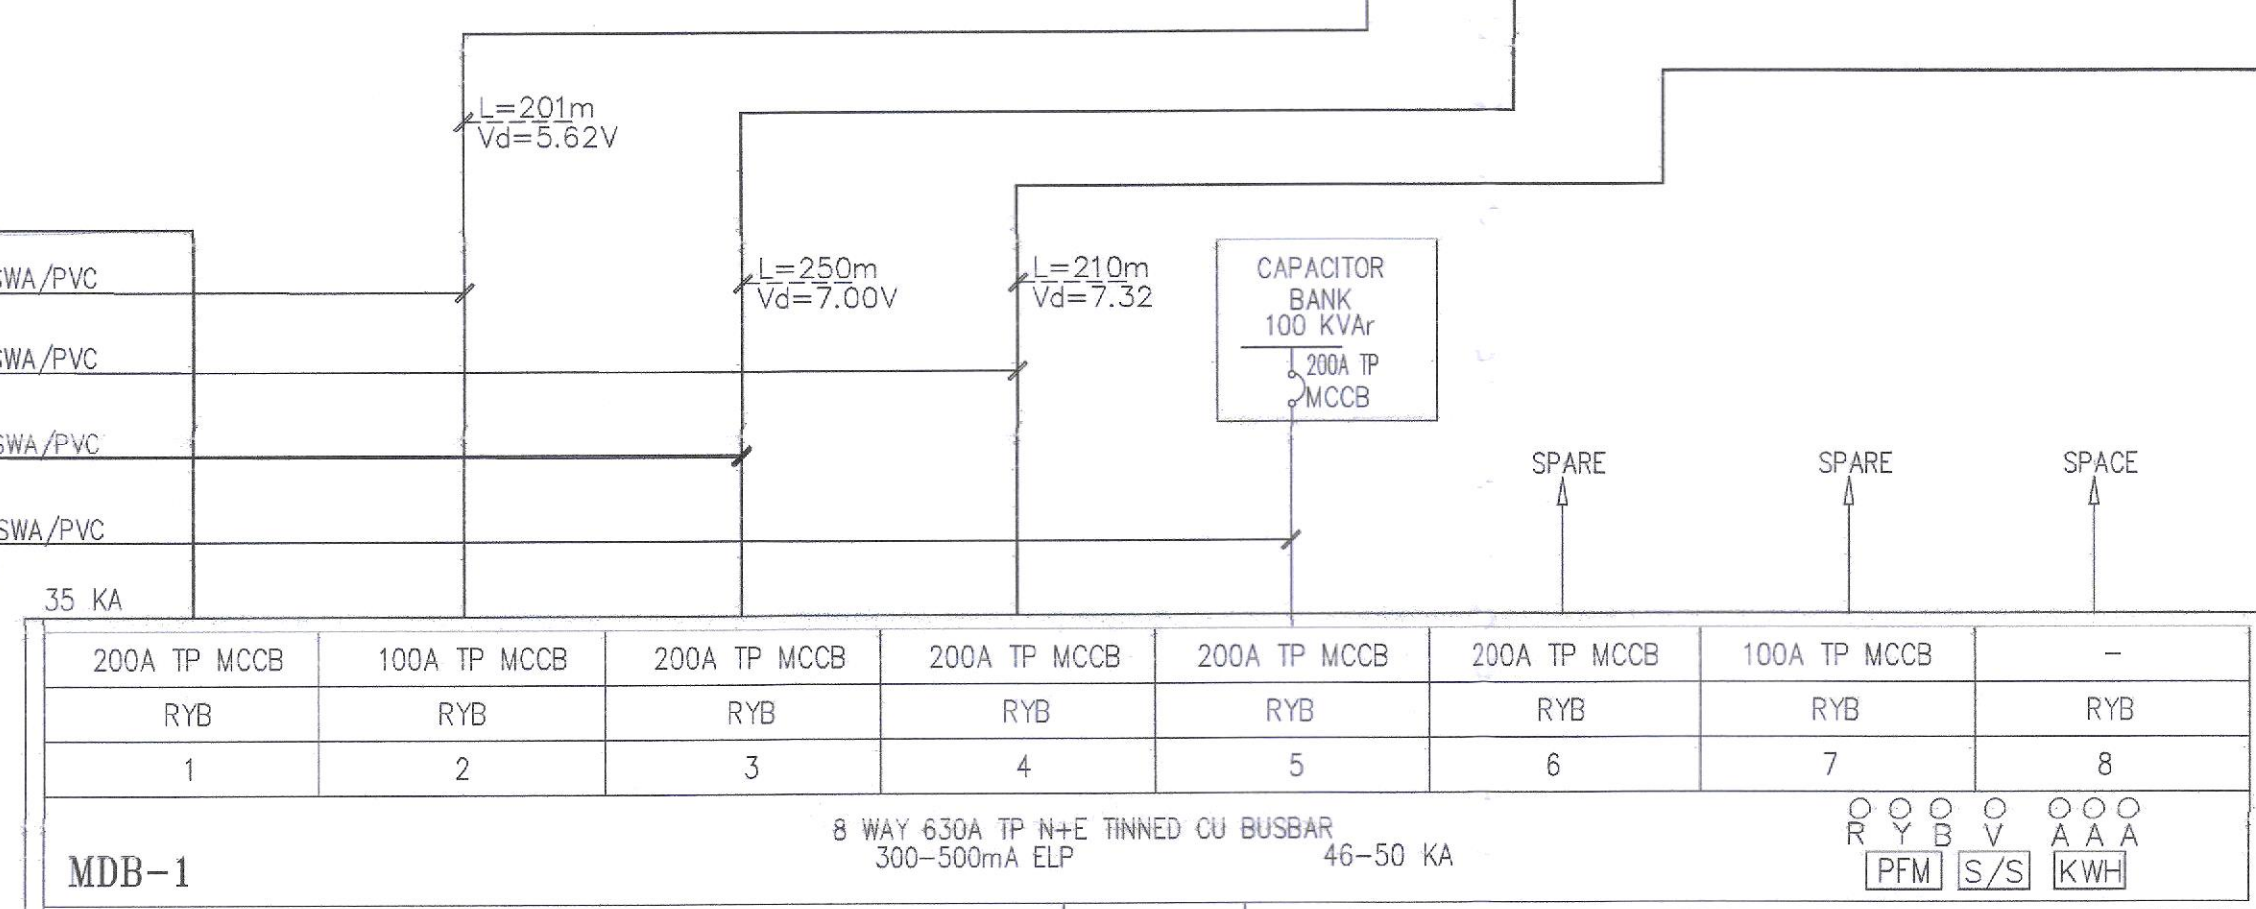
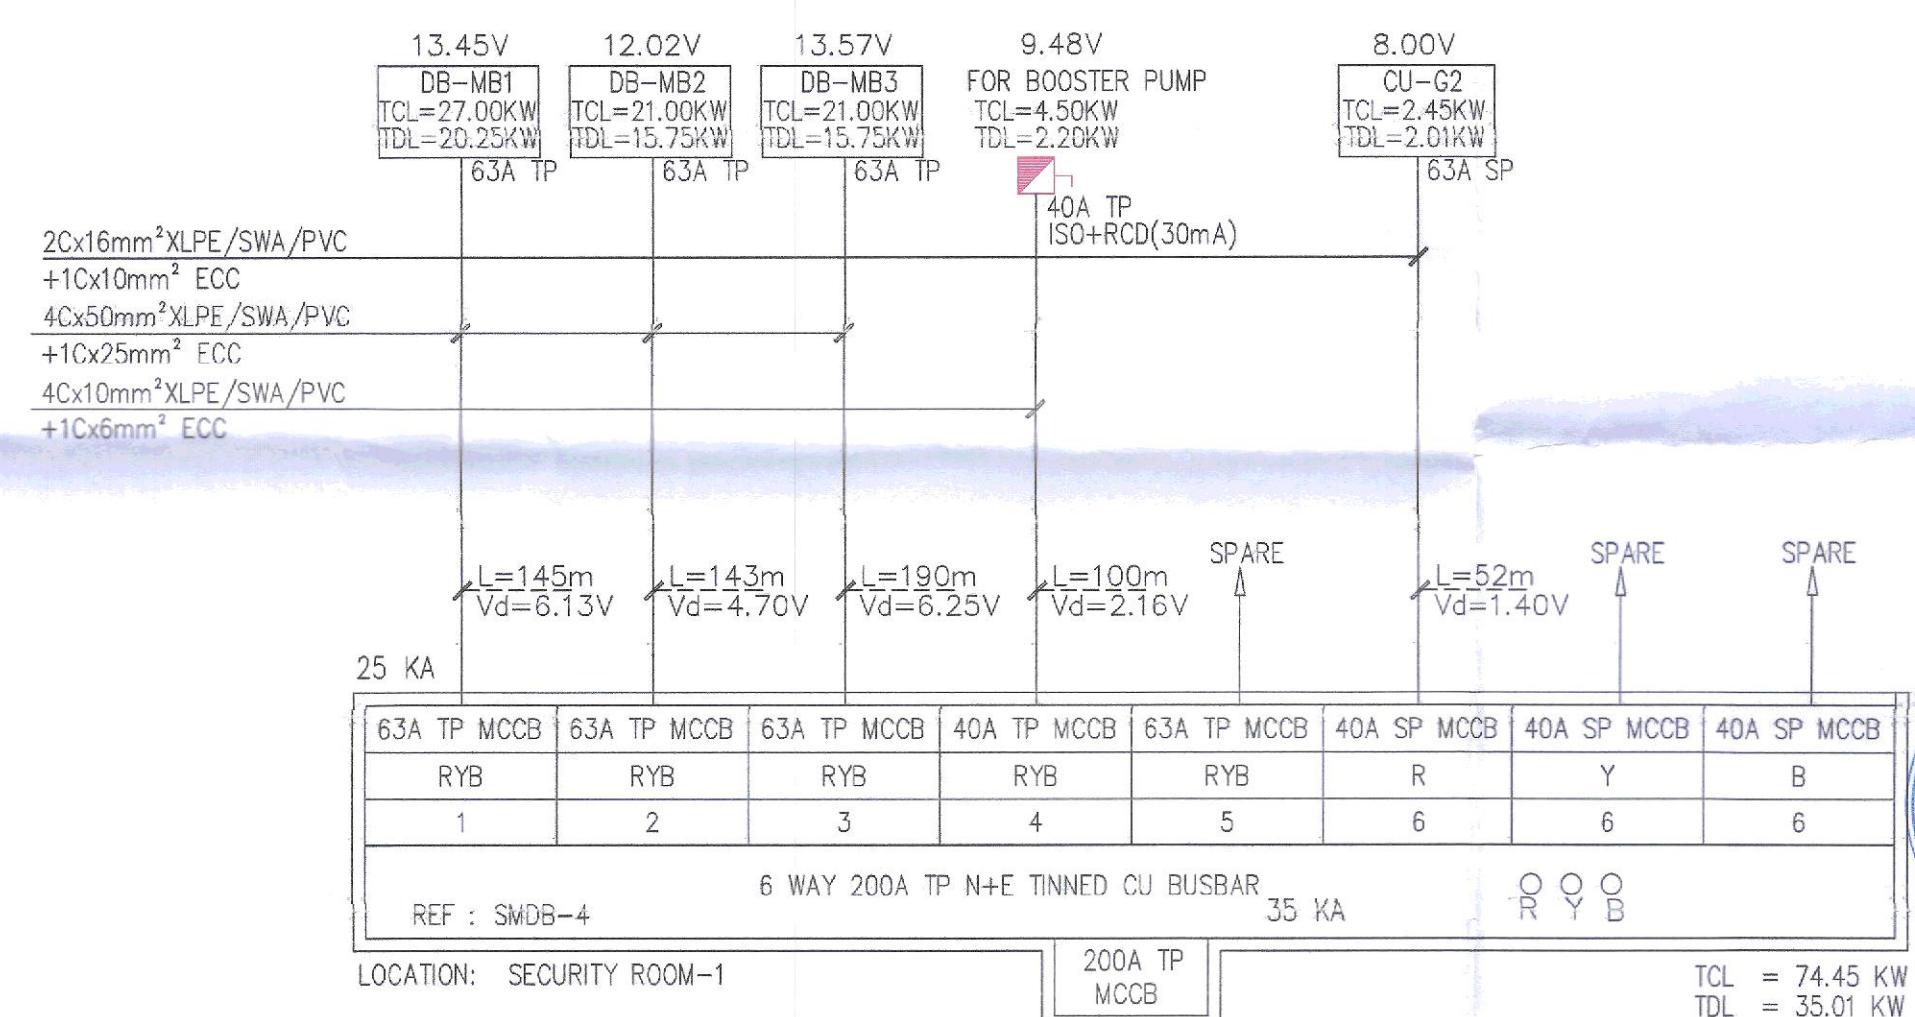
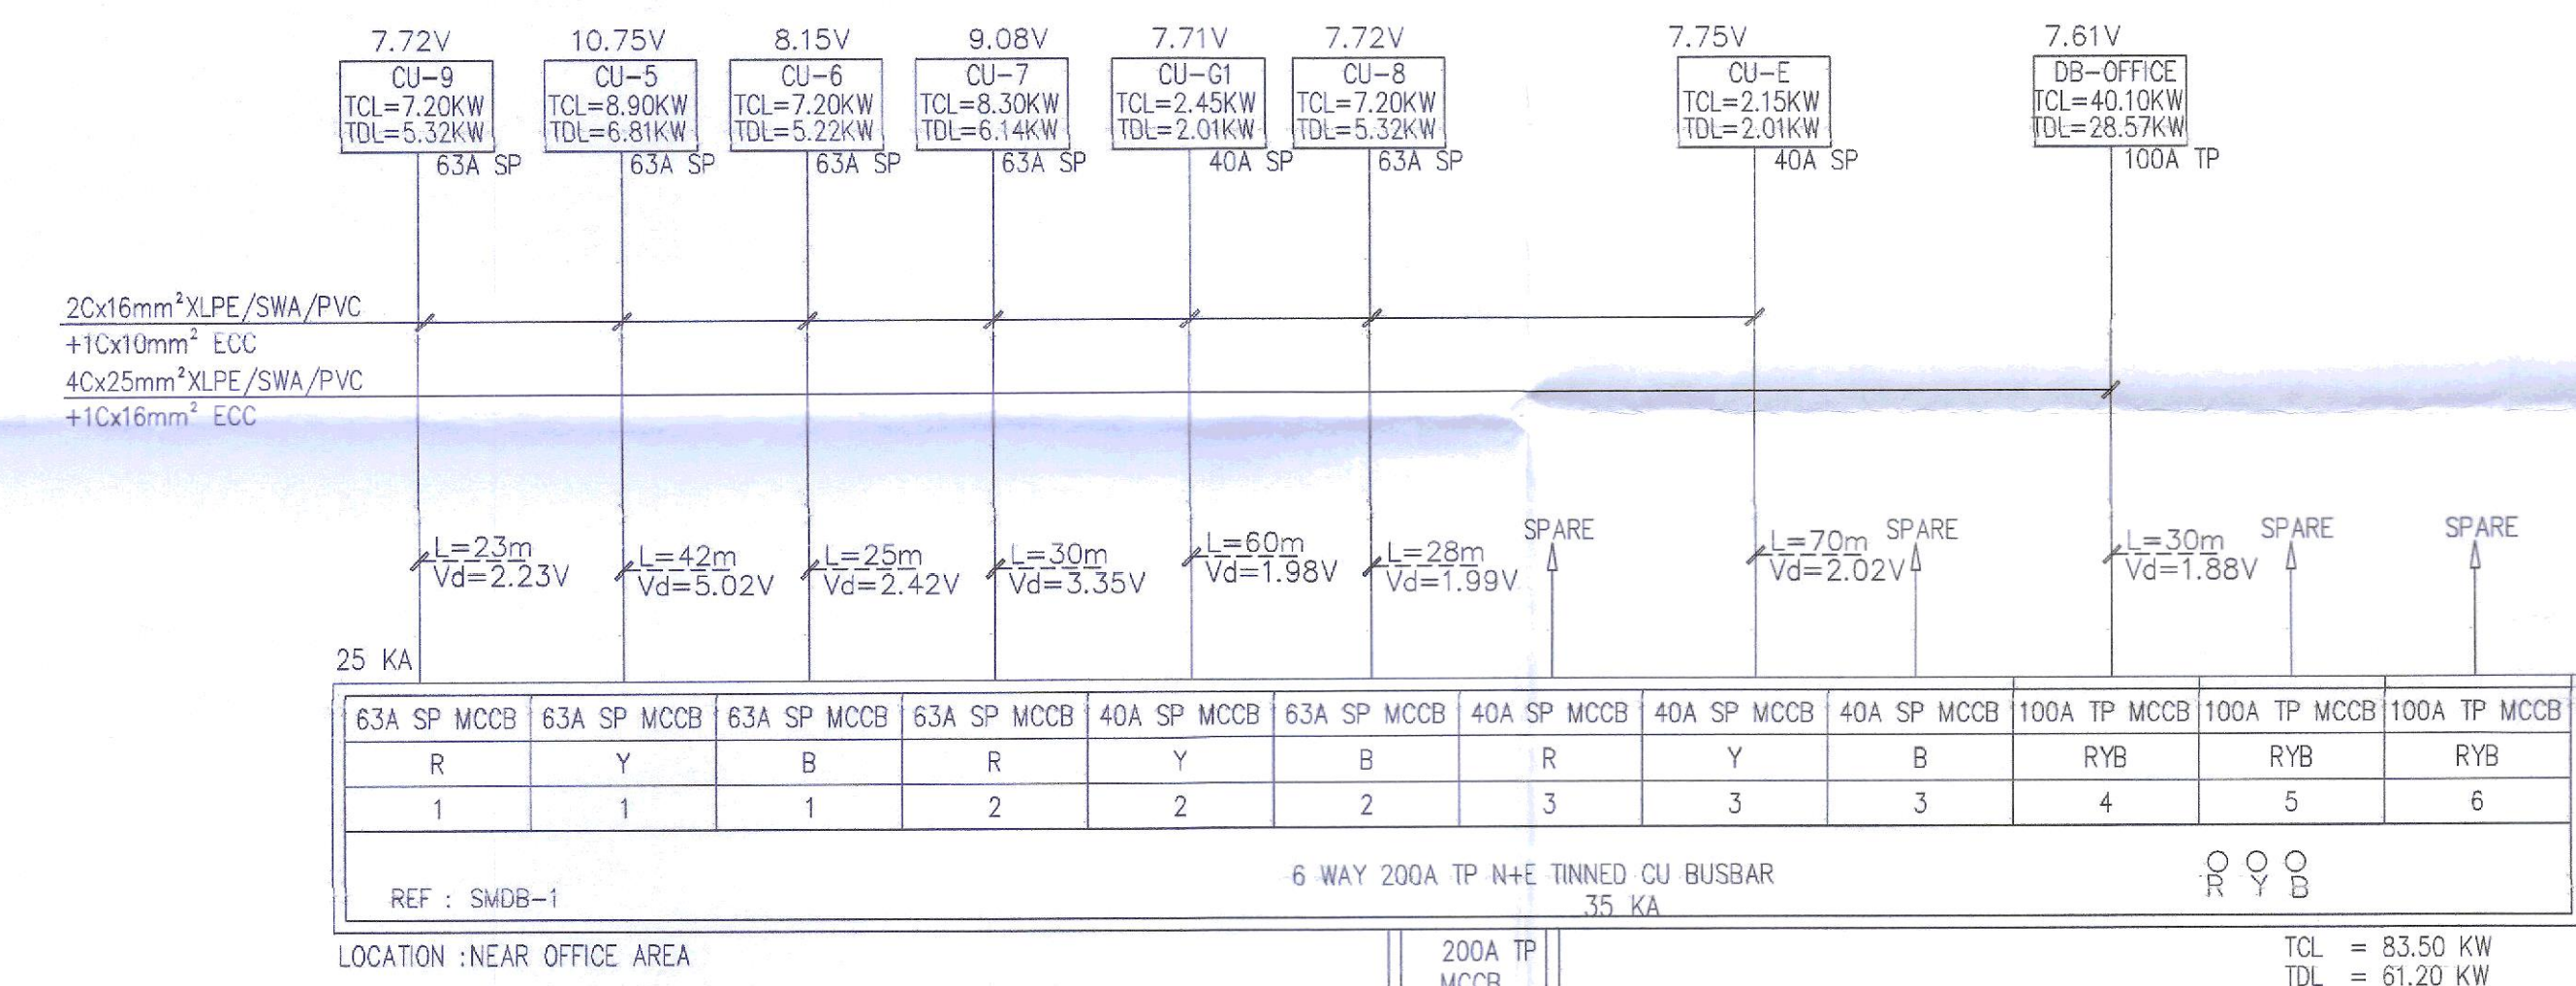
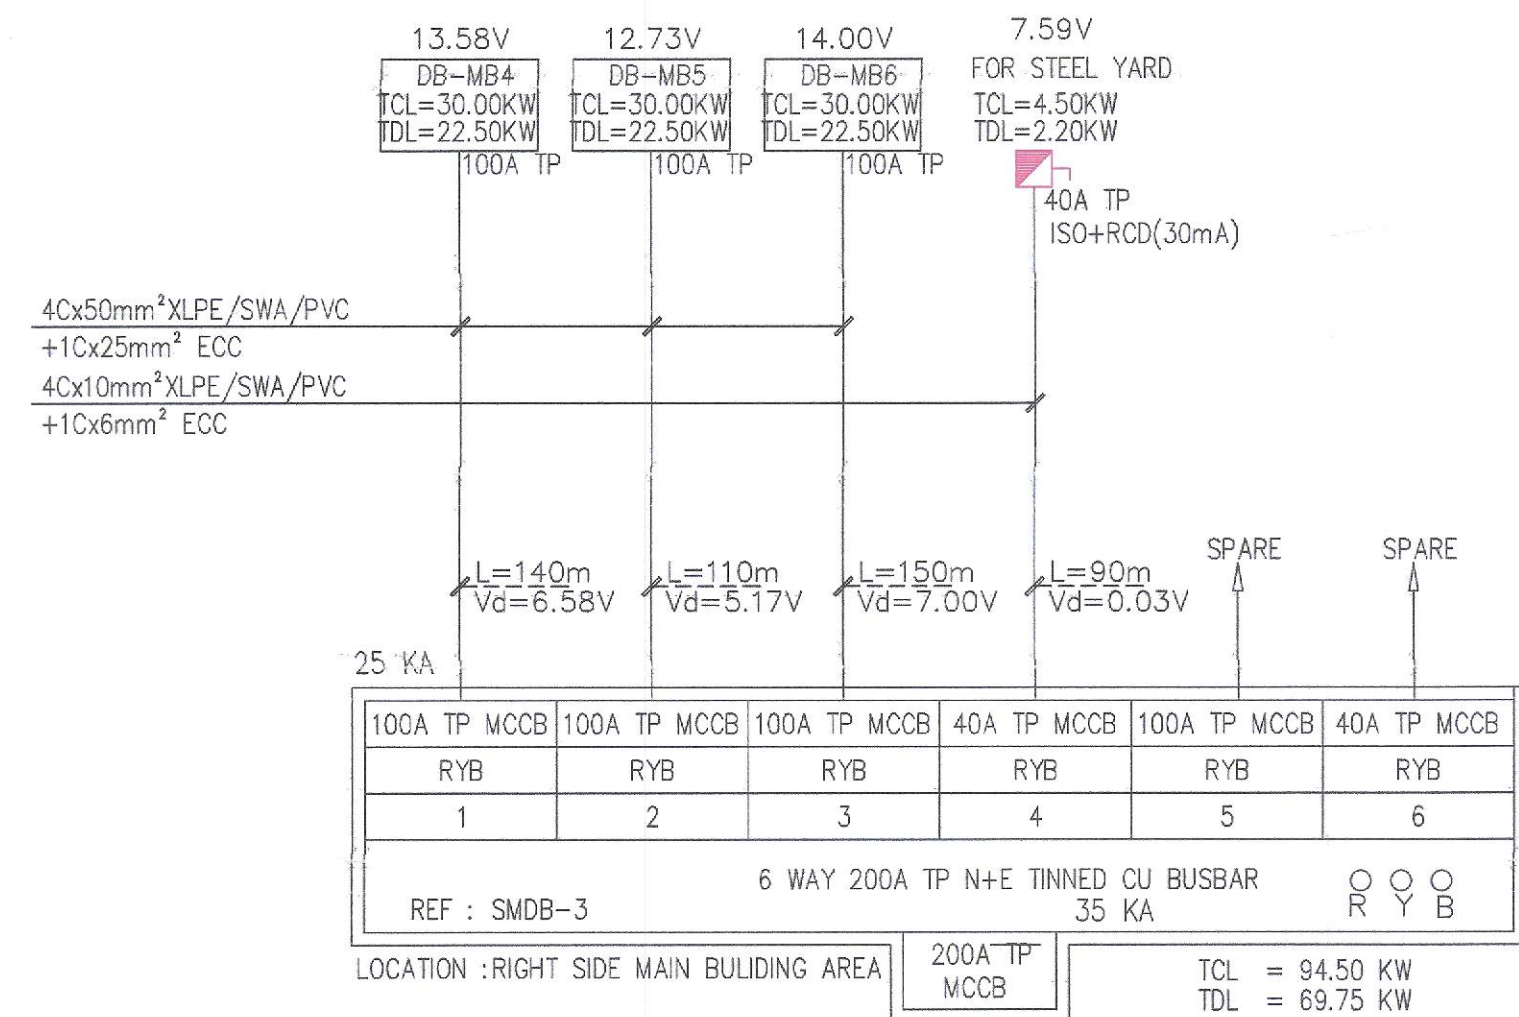


• All future installation that shown on this drawing must be constructed according to E

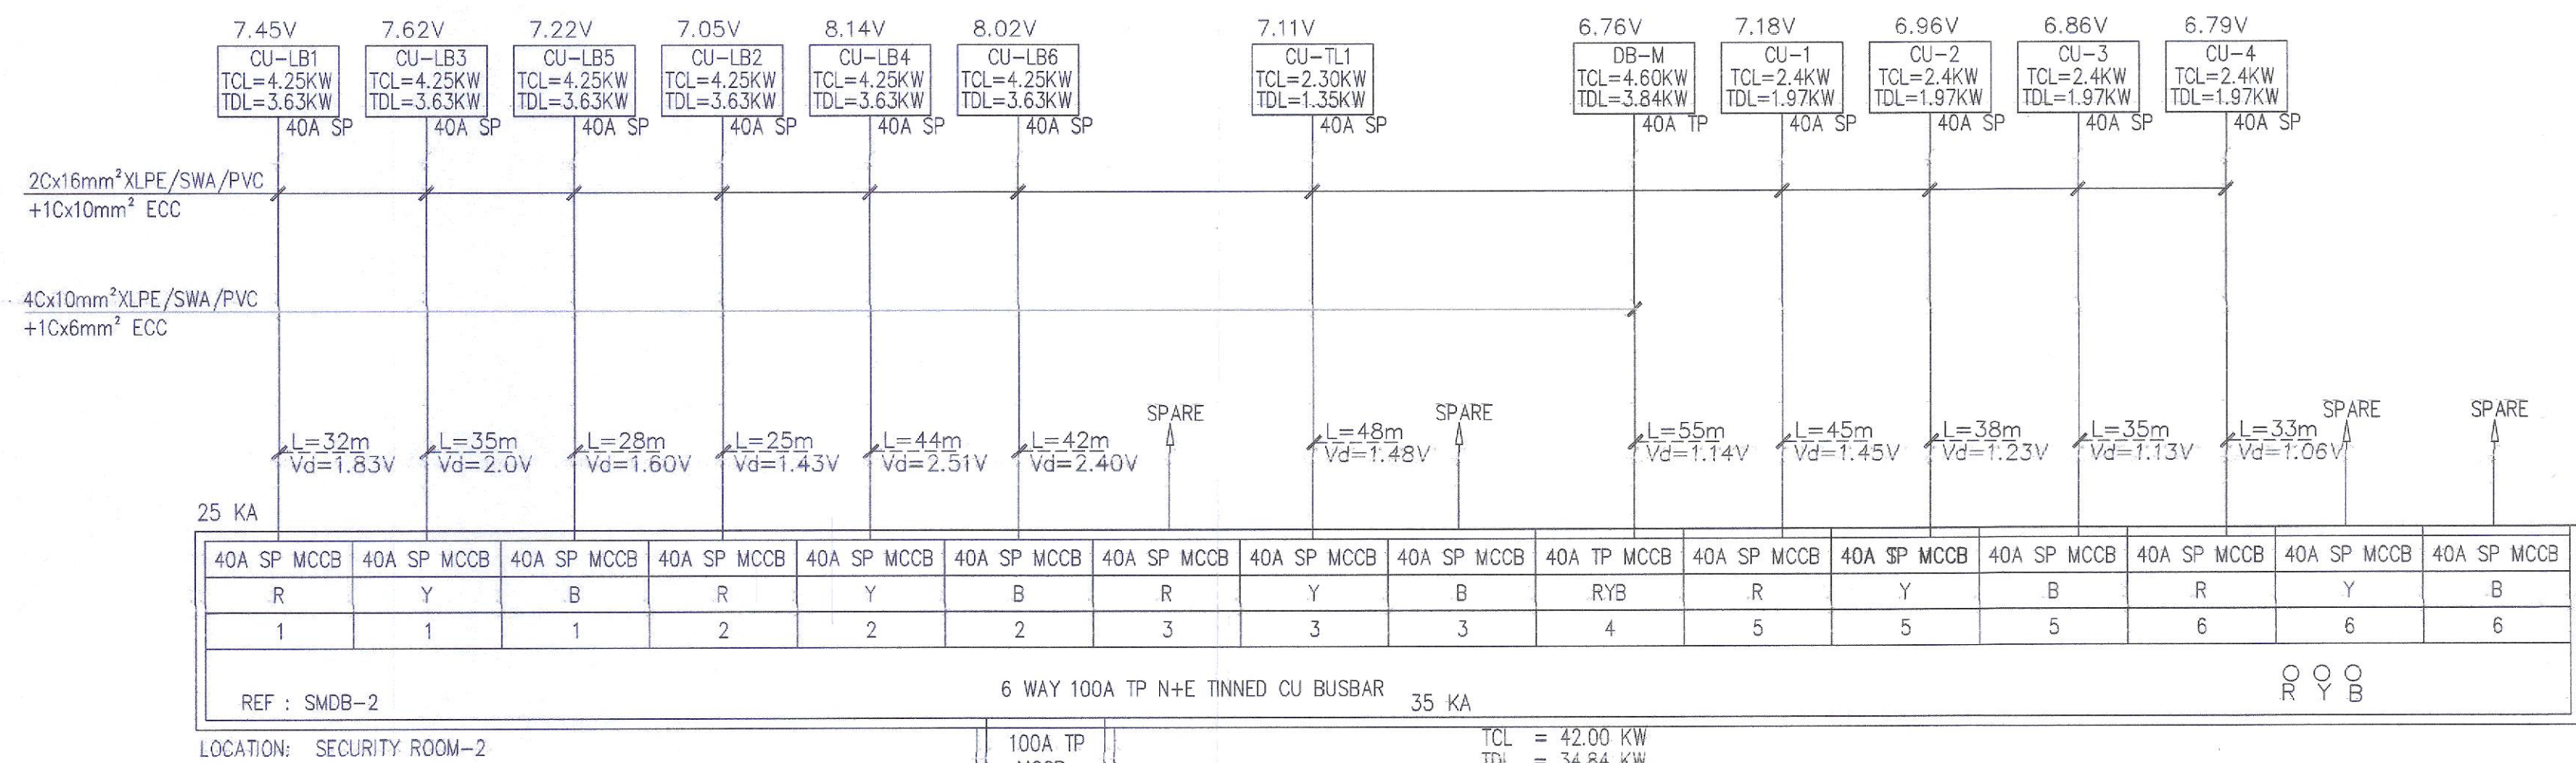

• From: EX.S/S No. DH-0162 4c/240mm CU

LAND KEY: SITE PLAN

GENERAL NOTES:

Case ID: 1384802986RQD-33593

APPROVED As Noted

SHOP DRAWING

ISSUED FOR APPROVAL 05-08-2019

OWNER: وزارة التعليم والتعليم العالي

EMPLOYER: Musanada

DESIGN CONSULTANT: Al Suweidi

PROJECT NAME: ADU DHABI FUTURE SCHOOLS PROGRAM (PHASE 8) BANIYAS-ABUDHABI CYCLE 1 & K2

ZONE: AL DHABER

SECTOR NO: AL DHABER PLOT NO: P18

PROJECT DESCRIPTION: PRE-DESIGNED SCHOOL IN AL DHABER FOR 1610 C1+K2 STUDENTS

DRAWING TITLE: SINGLE LINE DIAGRAM (TEMPORARY POWER SUPPLY)

DRAWING NO: AD-LV-SDL-01 REVISION NO: REV0

SUBMISSION DATE: 05-08-2019 SCALE: A1

PROJECT ID: ED-2-05-58980-2-B DRAWING SIZE: N.T.S

CHECKED BY: ENG HUSSAM DRAWN BY: AKHIL

OFFICIAL USE ONLY: